

CONTRACTOR'S SUBMITTAL TRANSMITTAL
 LANTDIV NORFOLK 4-4355/3 (Rev. 11-80)

7, 11

CONTRACT NO. 81-C-1766	TRANSMITTAL NO. 32	DATE 10 Aug 83
---------------------------	-----------------------	-------------------

FROM CONTRACTOR
 Trader Construction Company

TO
 Lockwood Greene/Six Associates

PROJECT TITLE AND LOCATION
 Public Works & Helipad
 MCB
 Camp Lejeune, N.C.

CONTRACTOR USE ONLY <i>*List only one specification division per form.</i> <i>List only one of the following categories on each transmittal form, and indicate which is being submitted</i> <input checked="" type="checkbox"/> Contractor Approved <input type="checkbox"/> OICC Approval <input type="checkbox"/> Deviation/Substitution For OICC Approval	REVIEWER USE ONLY **ACTION CODES A-Approved D-Disapproved AN-Approved as noted RA-Receipt acknowledged. C-Comments R-Resubmit
--	--

ITEM NO.	PROJ. SPEC. SECT. & PARA. and/or PROJ. DWG. NO. *	ITEM IDENTIFICATION (Type, size, model no., Mfg. name, dwg. or brochure number)	NO. OF COPIES	ACTION CODES **	REVIEWER'S INITIALS CODE AND DATE
146	09500	Reflected Ceiling Plan	6	AN/C	A.B. 22 Aug 83
		Shop Sdgs			

CONTRACTOR'S COMMENTS

Copy Filed 8-26-83

COPY OF TRANSMITTAL AND SUBMITTALS TO ROICC ROICC, Camp Lejeune, N.C.		CONTRACTOR REPRESENTATIVE (Signature) <i>John Mayo</i>
DATE RECEIVED BY REVIEWER 8/12/83	FROM (Reviewer) Six Associates, Inc.	TO Trader Construction Co.

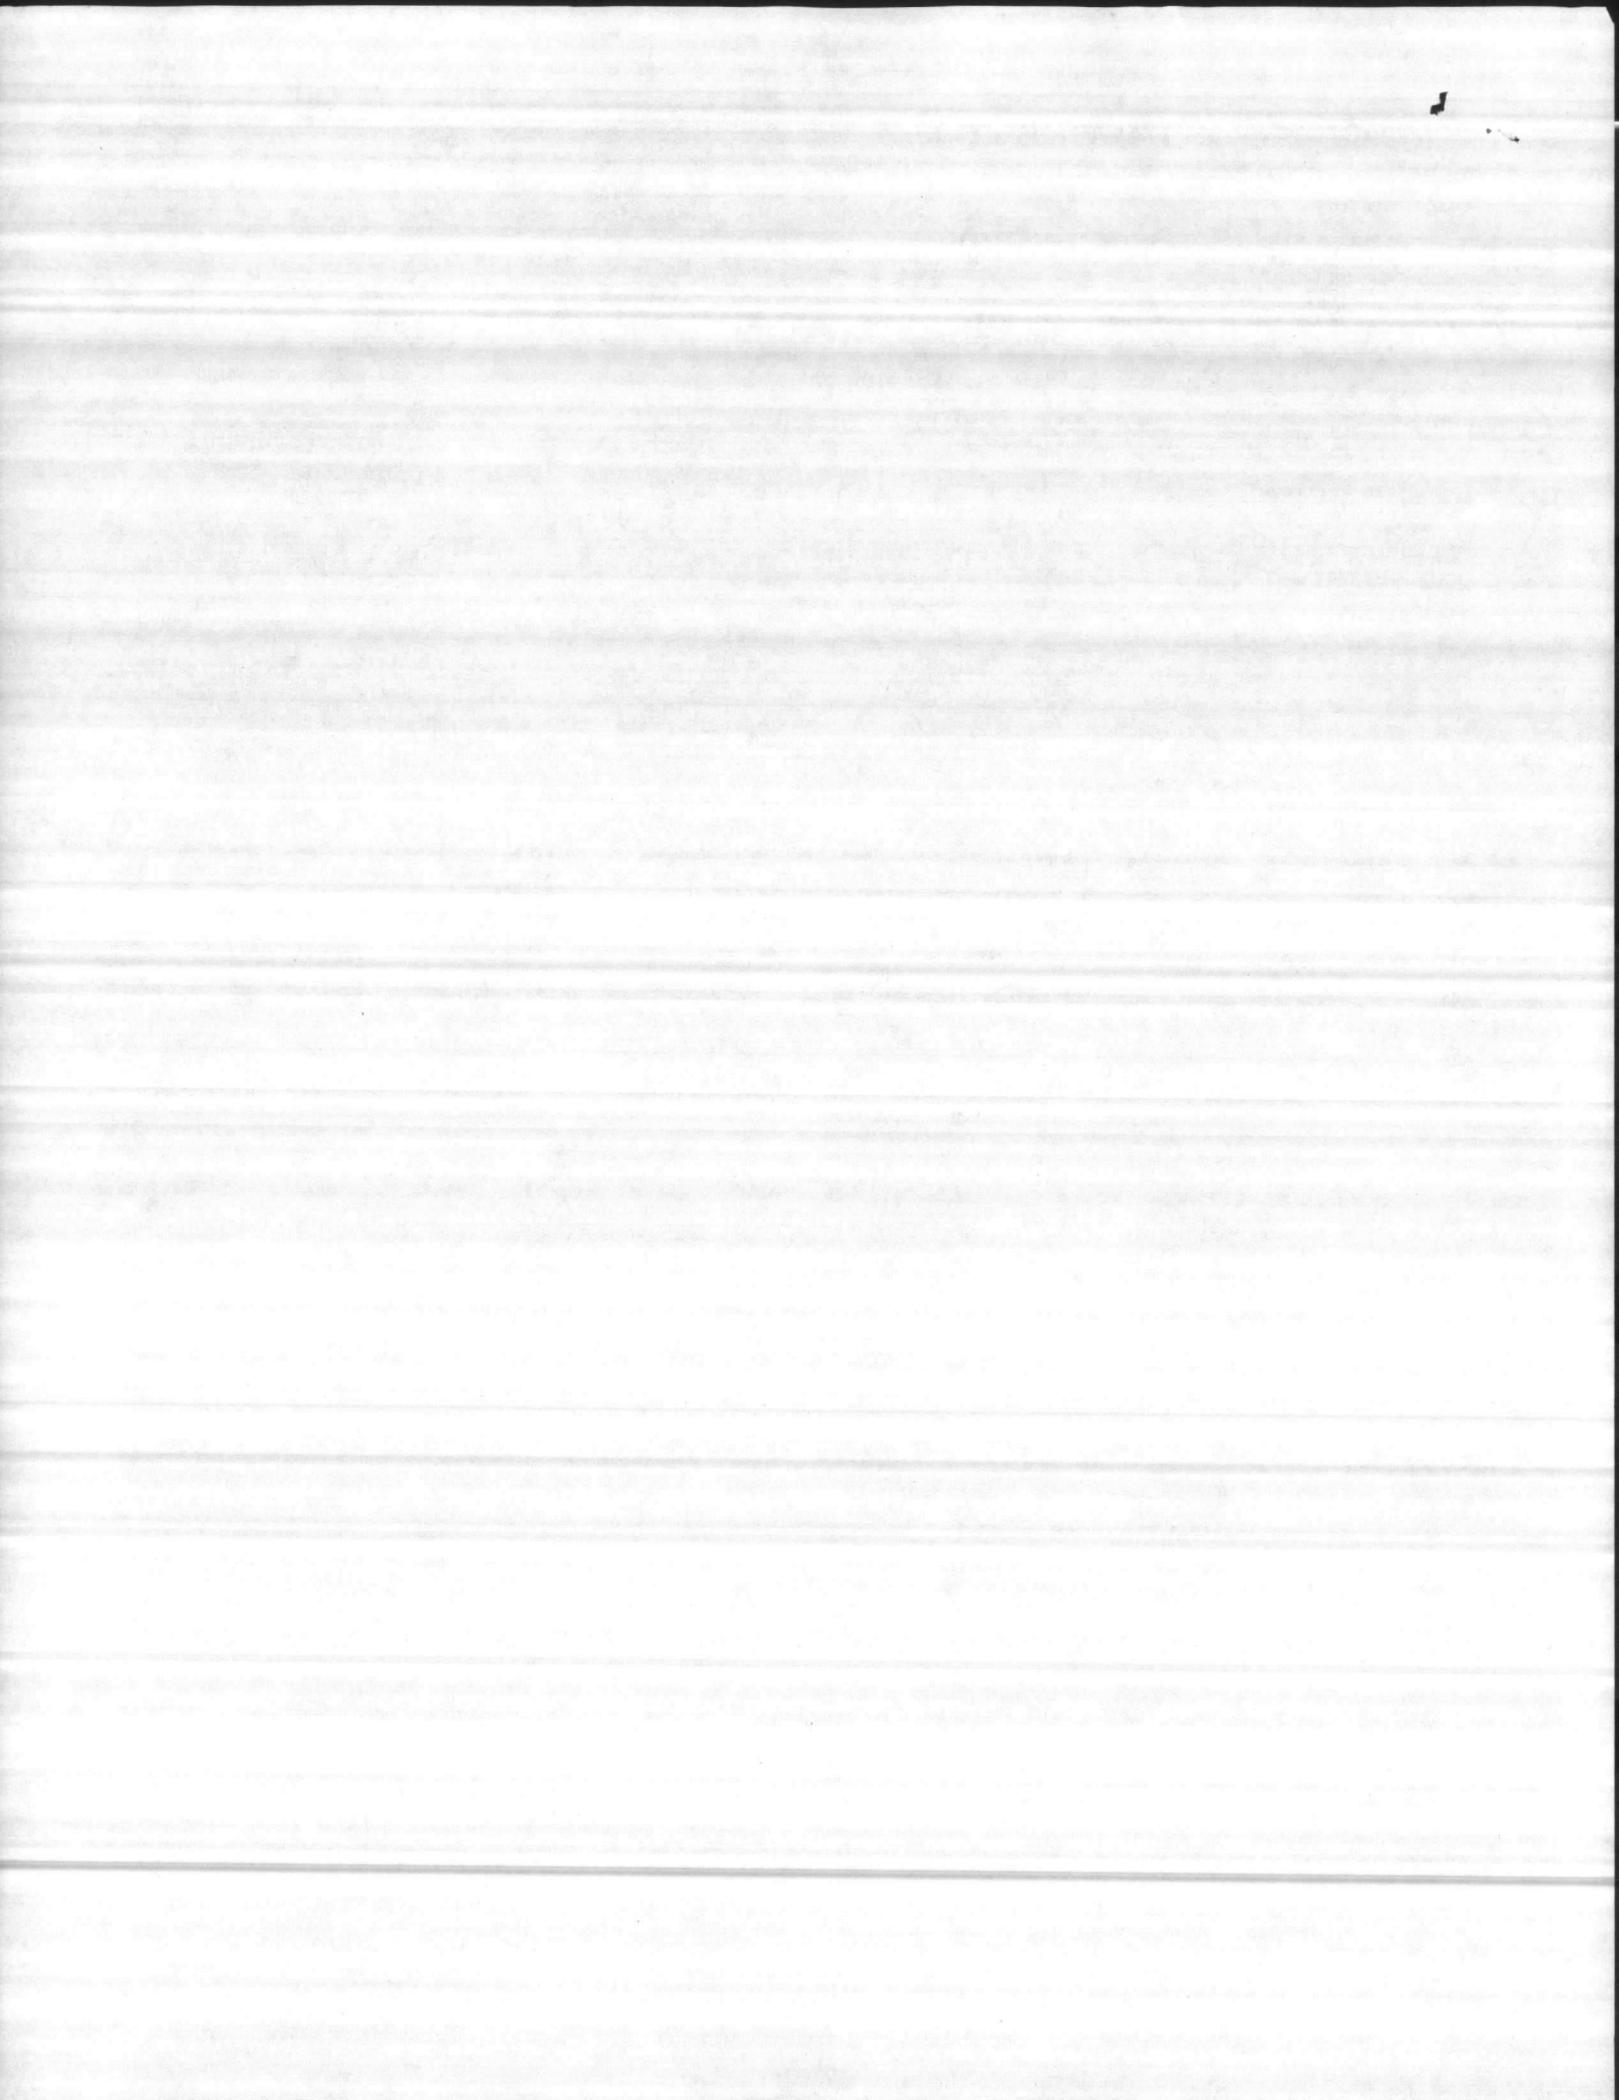
- Submittals are returned with action indicated. Approval of an item does not include approval of any deviation from the contract requirements unless the contractor calls attention to and supports the deviation.
- Submittals are forwarded to LANTDIV with A-E recommendations indicated in REVIEWER USE ONLY Section and in comments below on **ONE COPY** of the transmittal form.

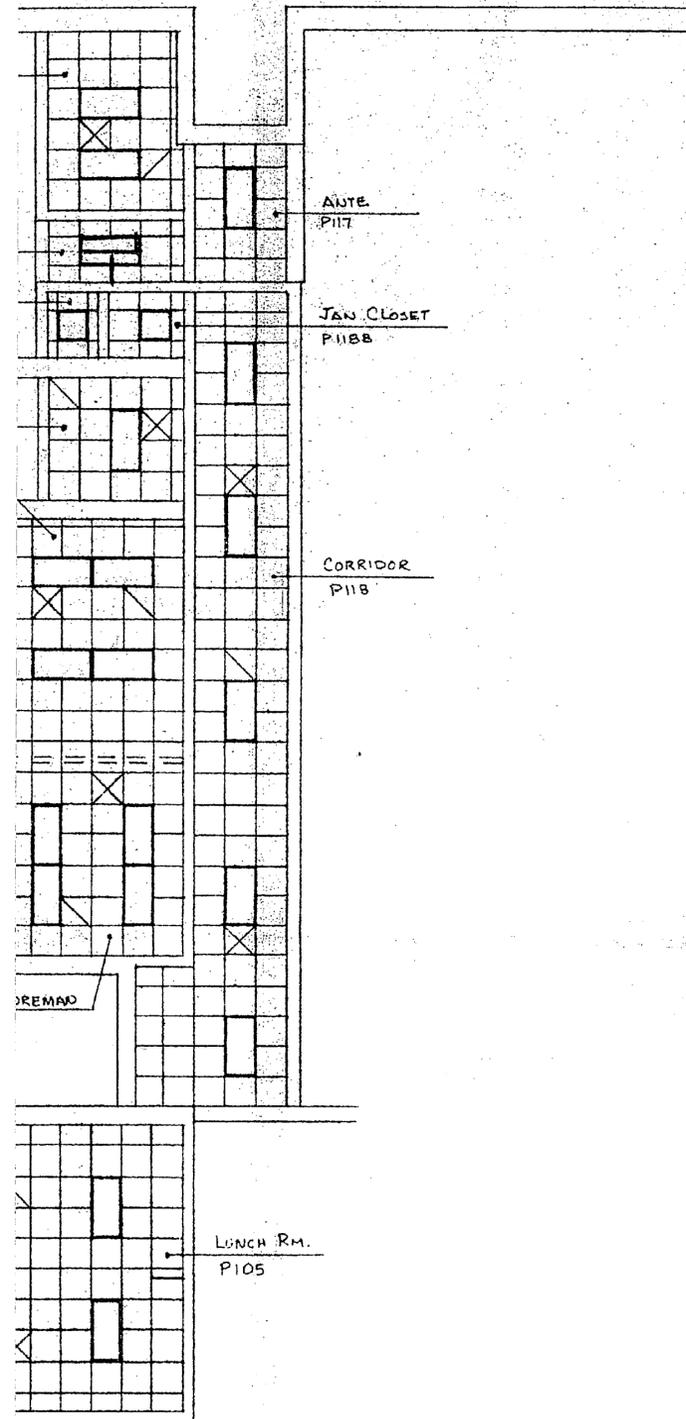
REVIEWER'S COMMENTS

NAVFAC letter dated 19 May 83 requires seven (7) submittals.




COPIES TO: ROICC (2) ✓ LANTDIV (1) A-E (1)	DATE 8/22/83	SIGNATURE <i>A.B. Joh</i>
---	-----------------	------------------------------

Stamp: 1533157





LEGEND:

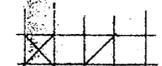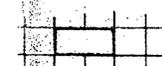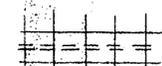-  2'x2' EXPOSED GRID SYSTEM WITH ?
-  2'x2' SUPPLY OR RETURN DIFFUSER, BY OTHERS.
-  2'x4' LAY-IN LIGHT FIXTURE, BY OTHERS.
-  INDICATES CEILING HIGH PARTITIONS, BY OTHERS.

BY TRADER

"It is hereby certified that the (equipment) (material) shown and marked in this submittal is that proposed to be incorporated into Contract Number W9470-D-C-1766 in compliance with the Contract drawings and specifications, and is installed in the attached spaces, and is submitted Government approval.
 Certified by Jim
 Date 10 Aug 83"

CEILING PLAN

acoustics incorporated
 3324 PELTON STREET POST OFFICE BOX 38204
 CHARLOTTE, N. C. 28236



DATE: 6-15-83
 DRAWN BY: R. STEPP
 CHECKED BY:

JOB: PUBLIC WORKS BUILDING
 LOCATION: CAMP LEJEUNE, NORTH CAROLINA
 ARCHITECT: NAVAL FACILITIES ENGR. COMMAND
 CONTRACTOR:
 REFLECTED CEILING PLAN

SHEET NO.
 1 of 1

